



*BOB'S MORNING BEAR  
CULTIVATION FACILITY*

BRENNAN NORDEN  
21725 EVELYN MAY ST.  
KASILOF, AK. 99610  
907-252-8868

08/03/2016


10/21/2016

LICENSED PREMISE: 1120 SF  
CULTIVATION CANOPY: 500 SF  
RESTRICTED ACCESS: 871 SF


SHEET INDEX	
SHEET NO.	SUBJECT
1	COVER - GENERAL NOTES, & INDEX
C1	SITE / SECURITY PLAN
A2	ASBUILT FLOOR PLAN
A2.1	ELECTRICAL PLAN, ASBUILT
A2.2	EQUIPMENT PLAN, ASBUILT
A2.3	REFLECTED CEILING PLAN
A3	ELEVATIONS
A3.1	TYP WALL SECTION
.	.
.	.


TYPE 'V' CONSTRUCTION  
OCCUPANCY TYPE: F2


KPB FILE NO. KN 0860122  
PARCEL ID 13723056  
0.99 ACRES  
BENCHMARK SD, RENAULT 1986 SUB,  
TRACT D, LOT 30

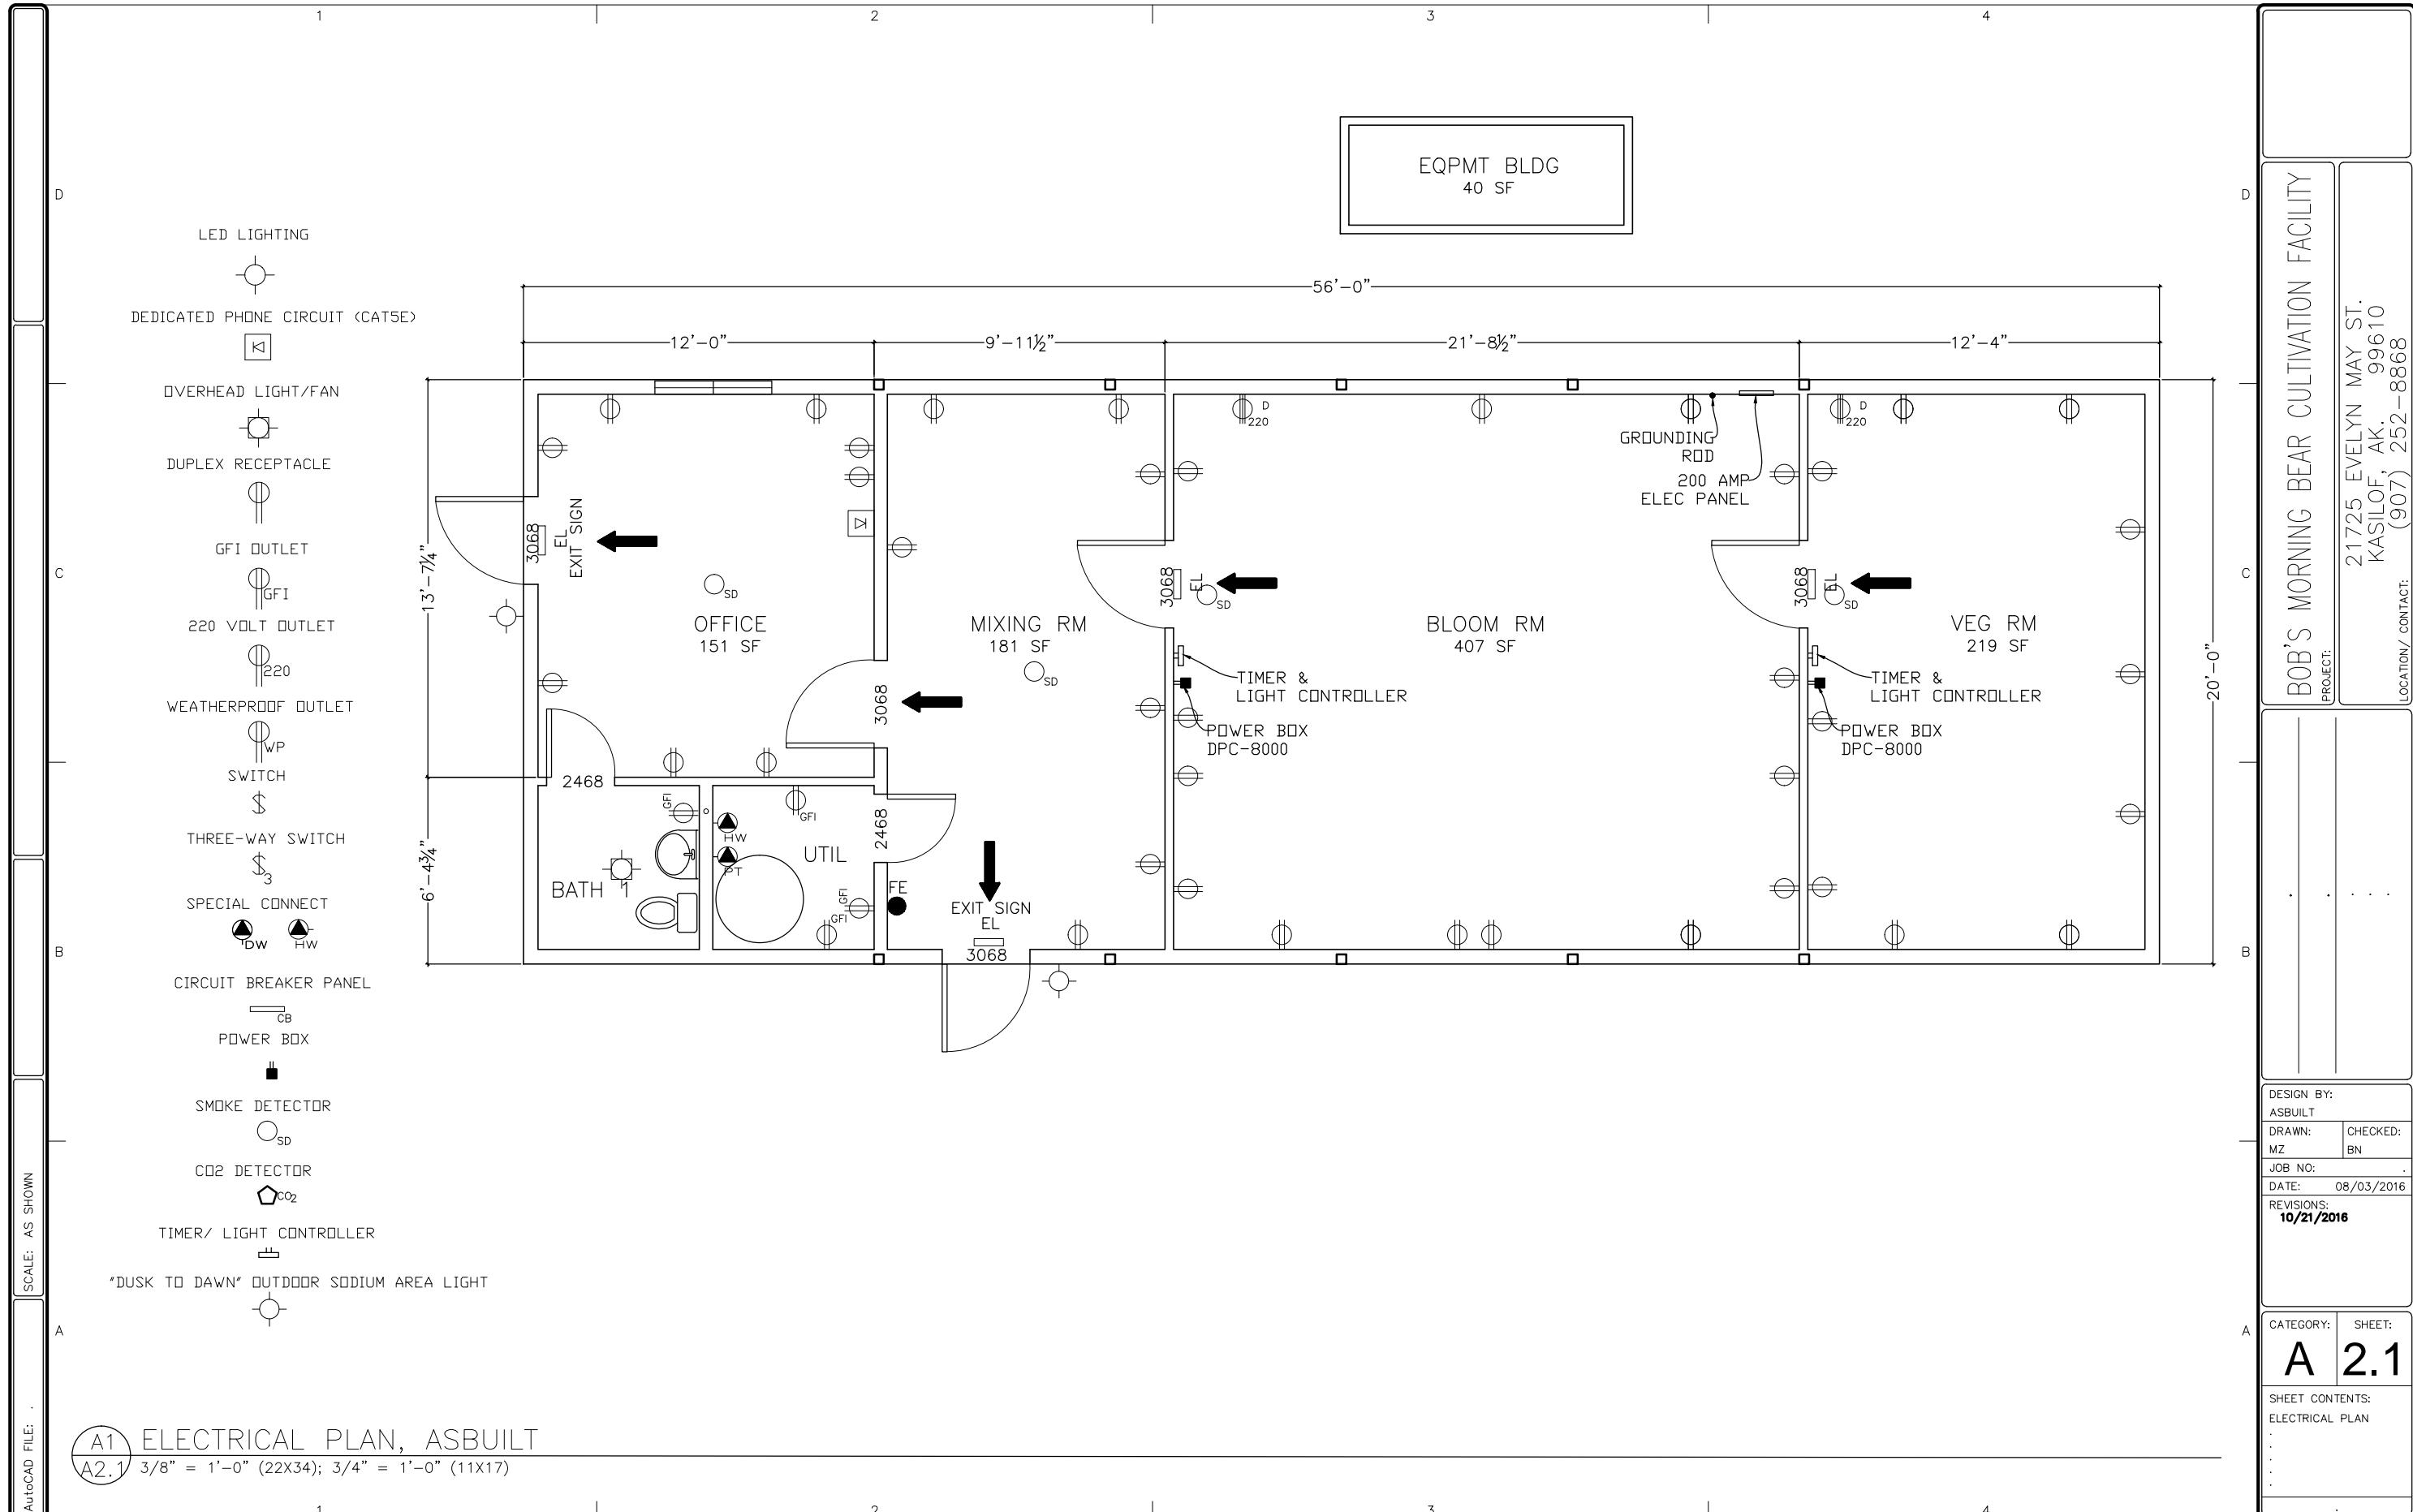

A1 ELECTRICAL PLAN, ASBUILT  
A2.1 3/8" = 1'-0" (22X34); 3/4" = 1'-0" (11X17)

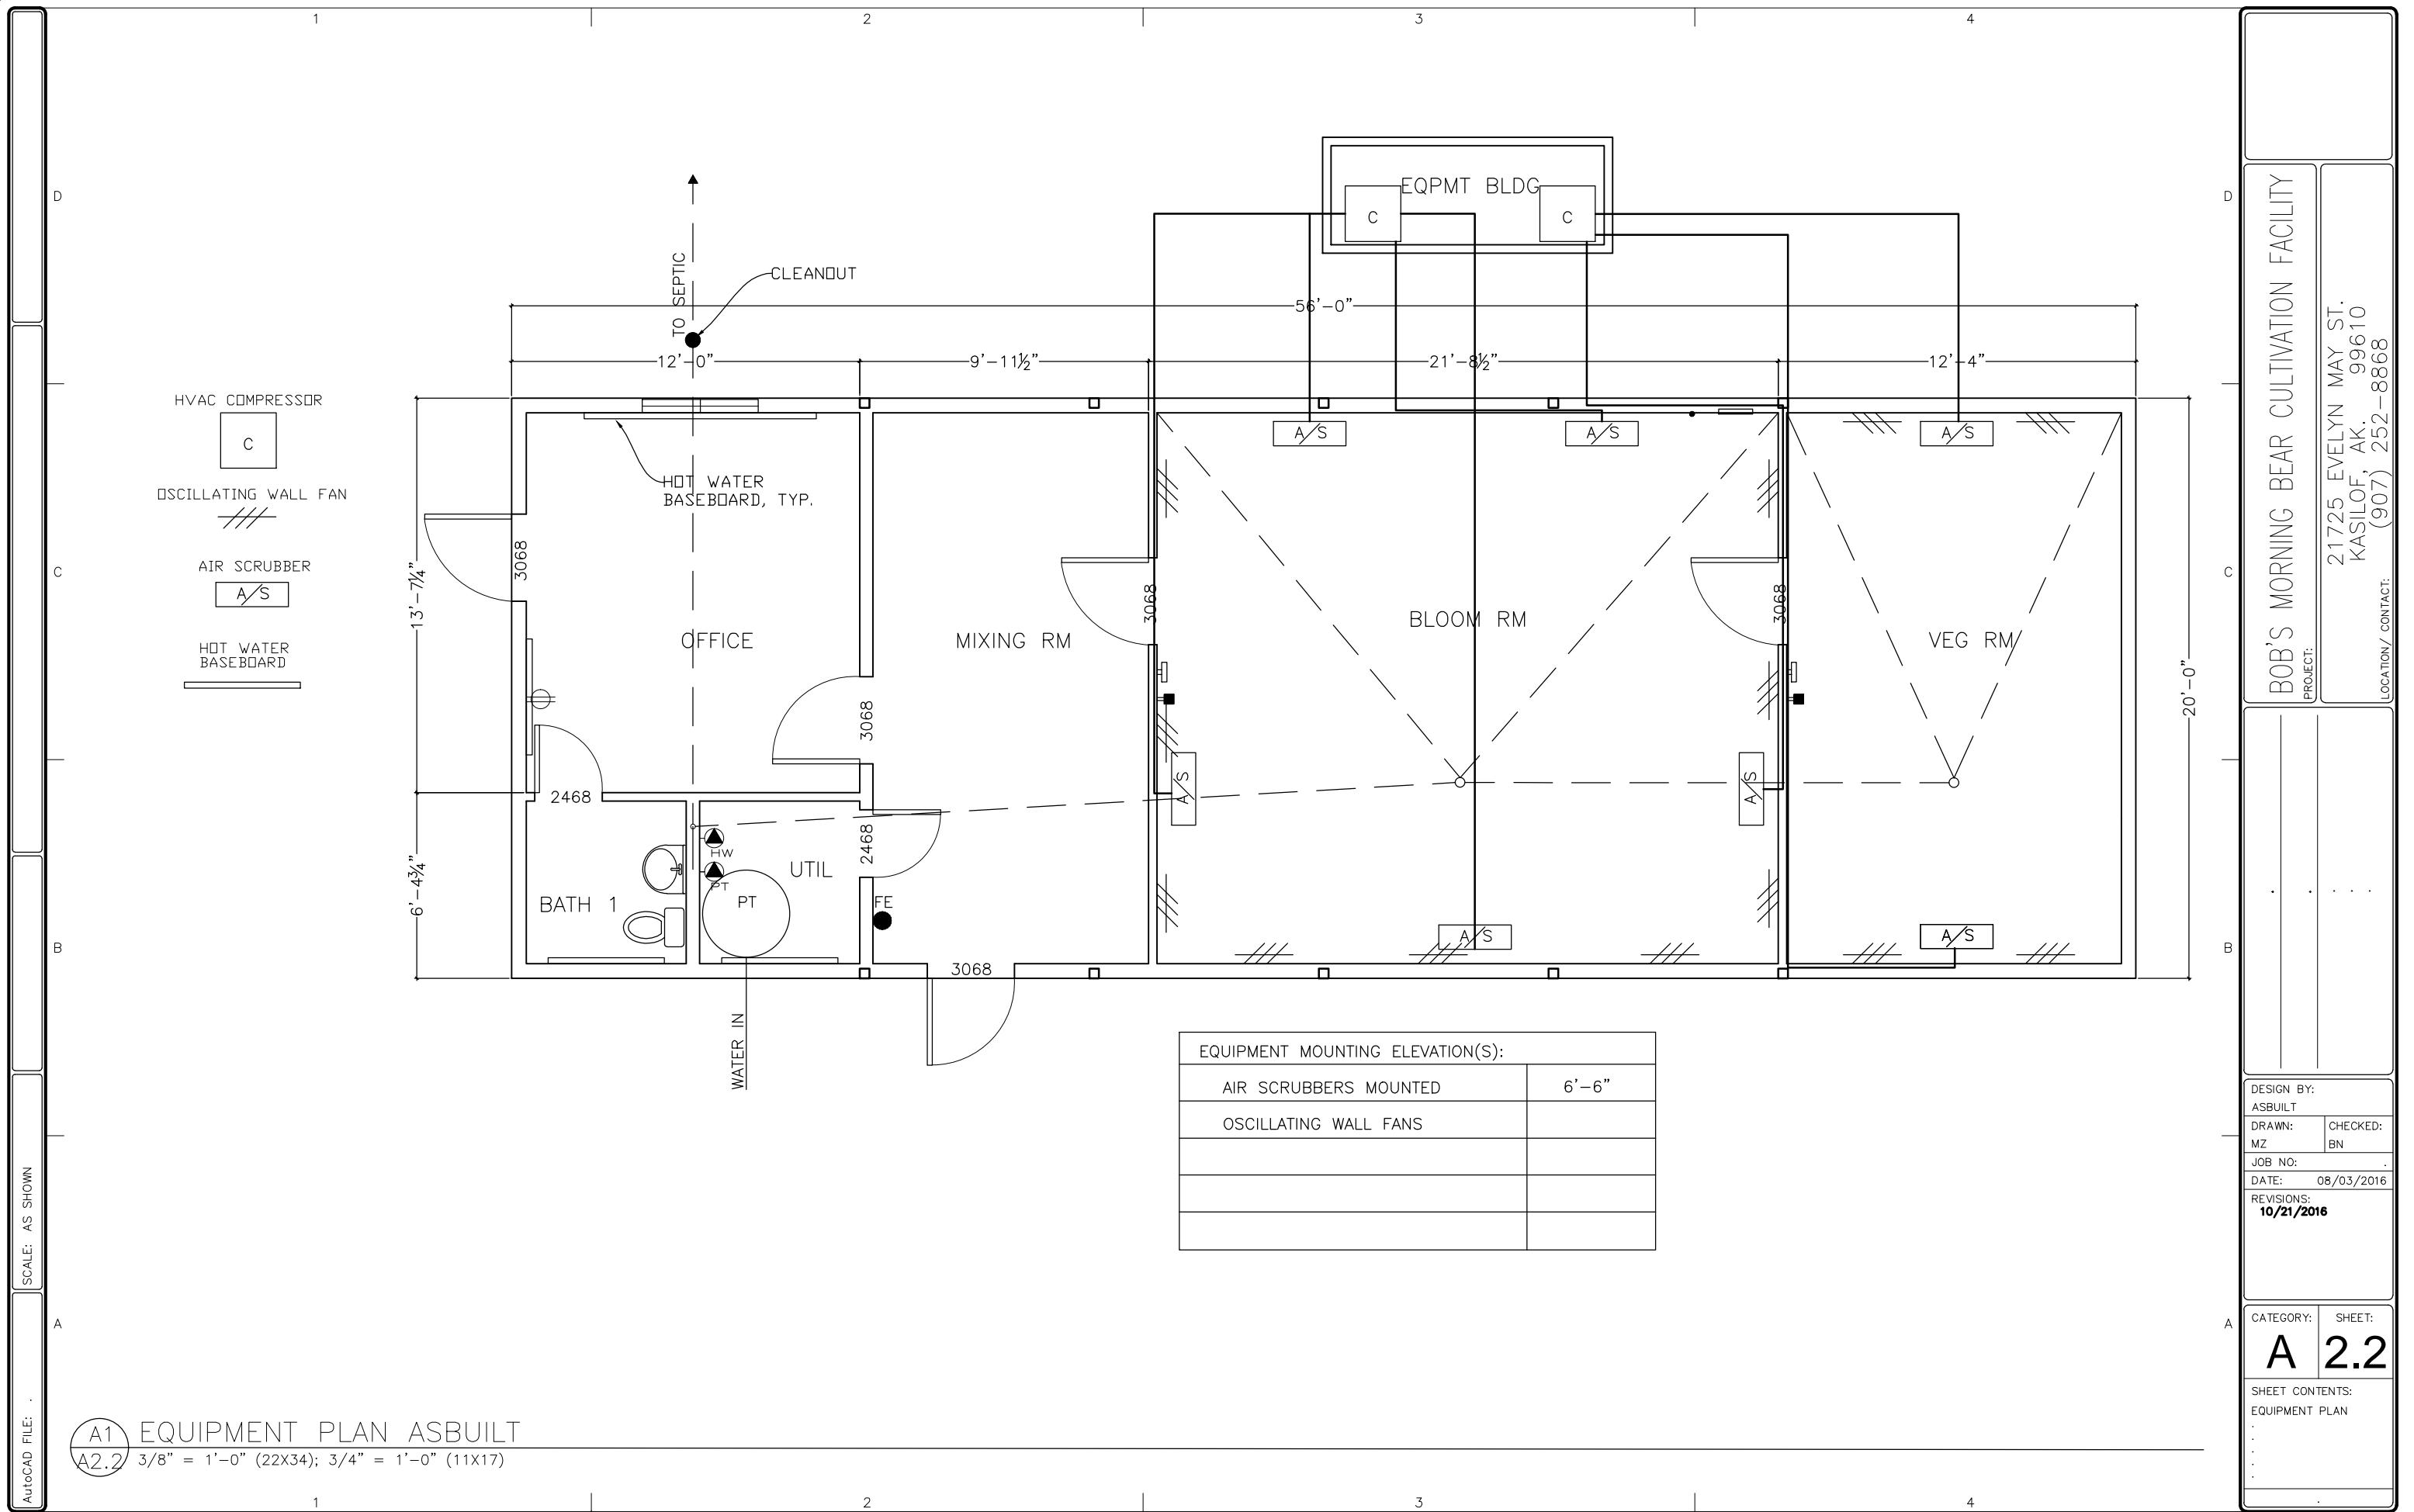

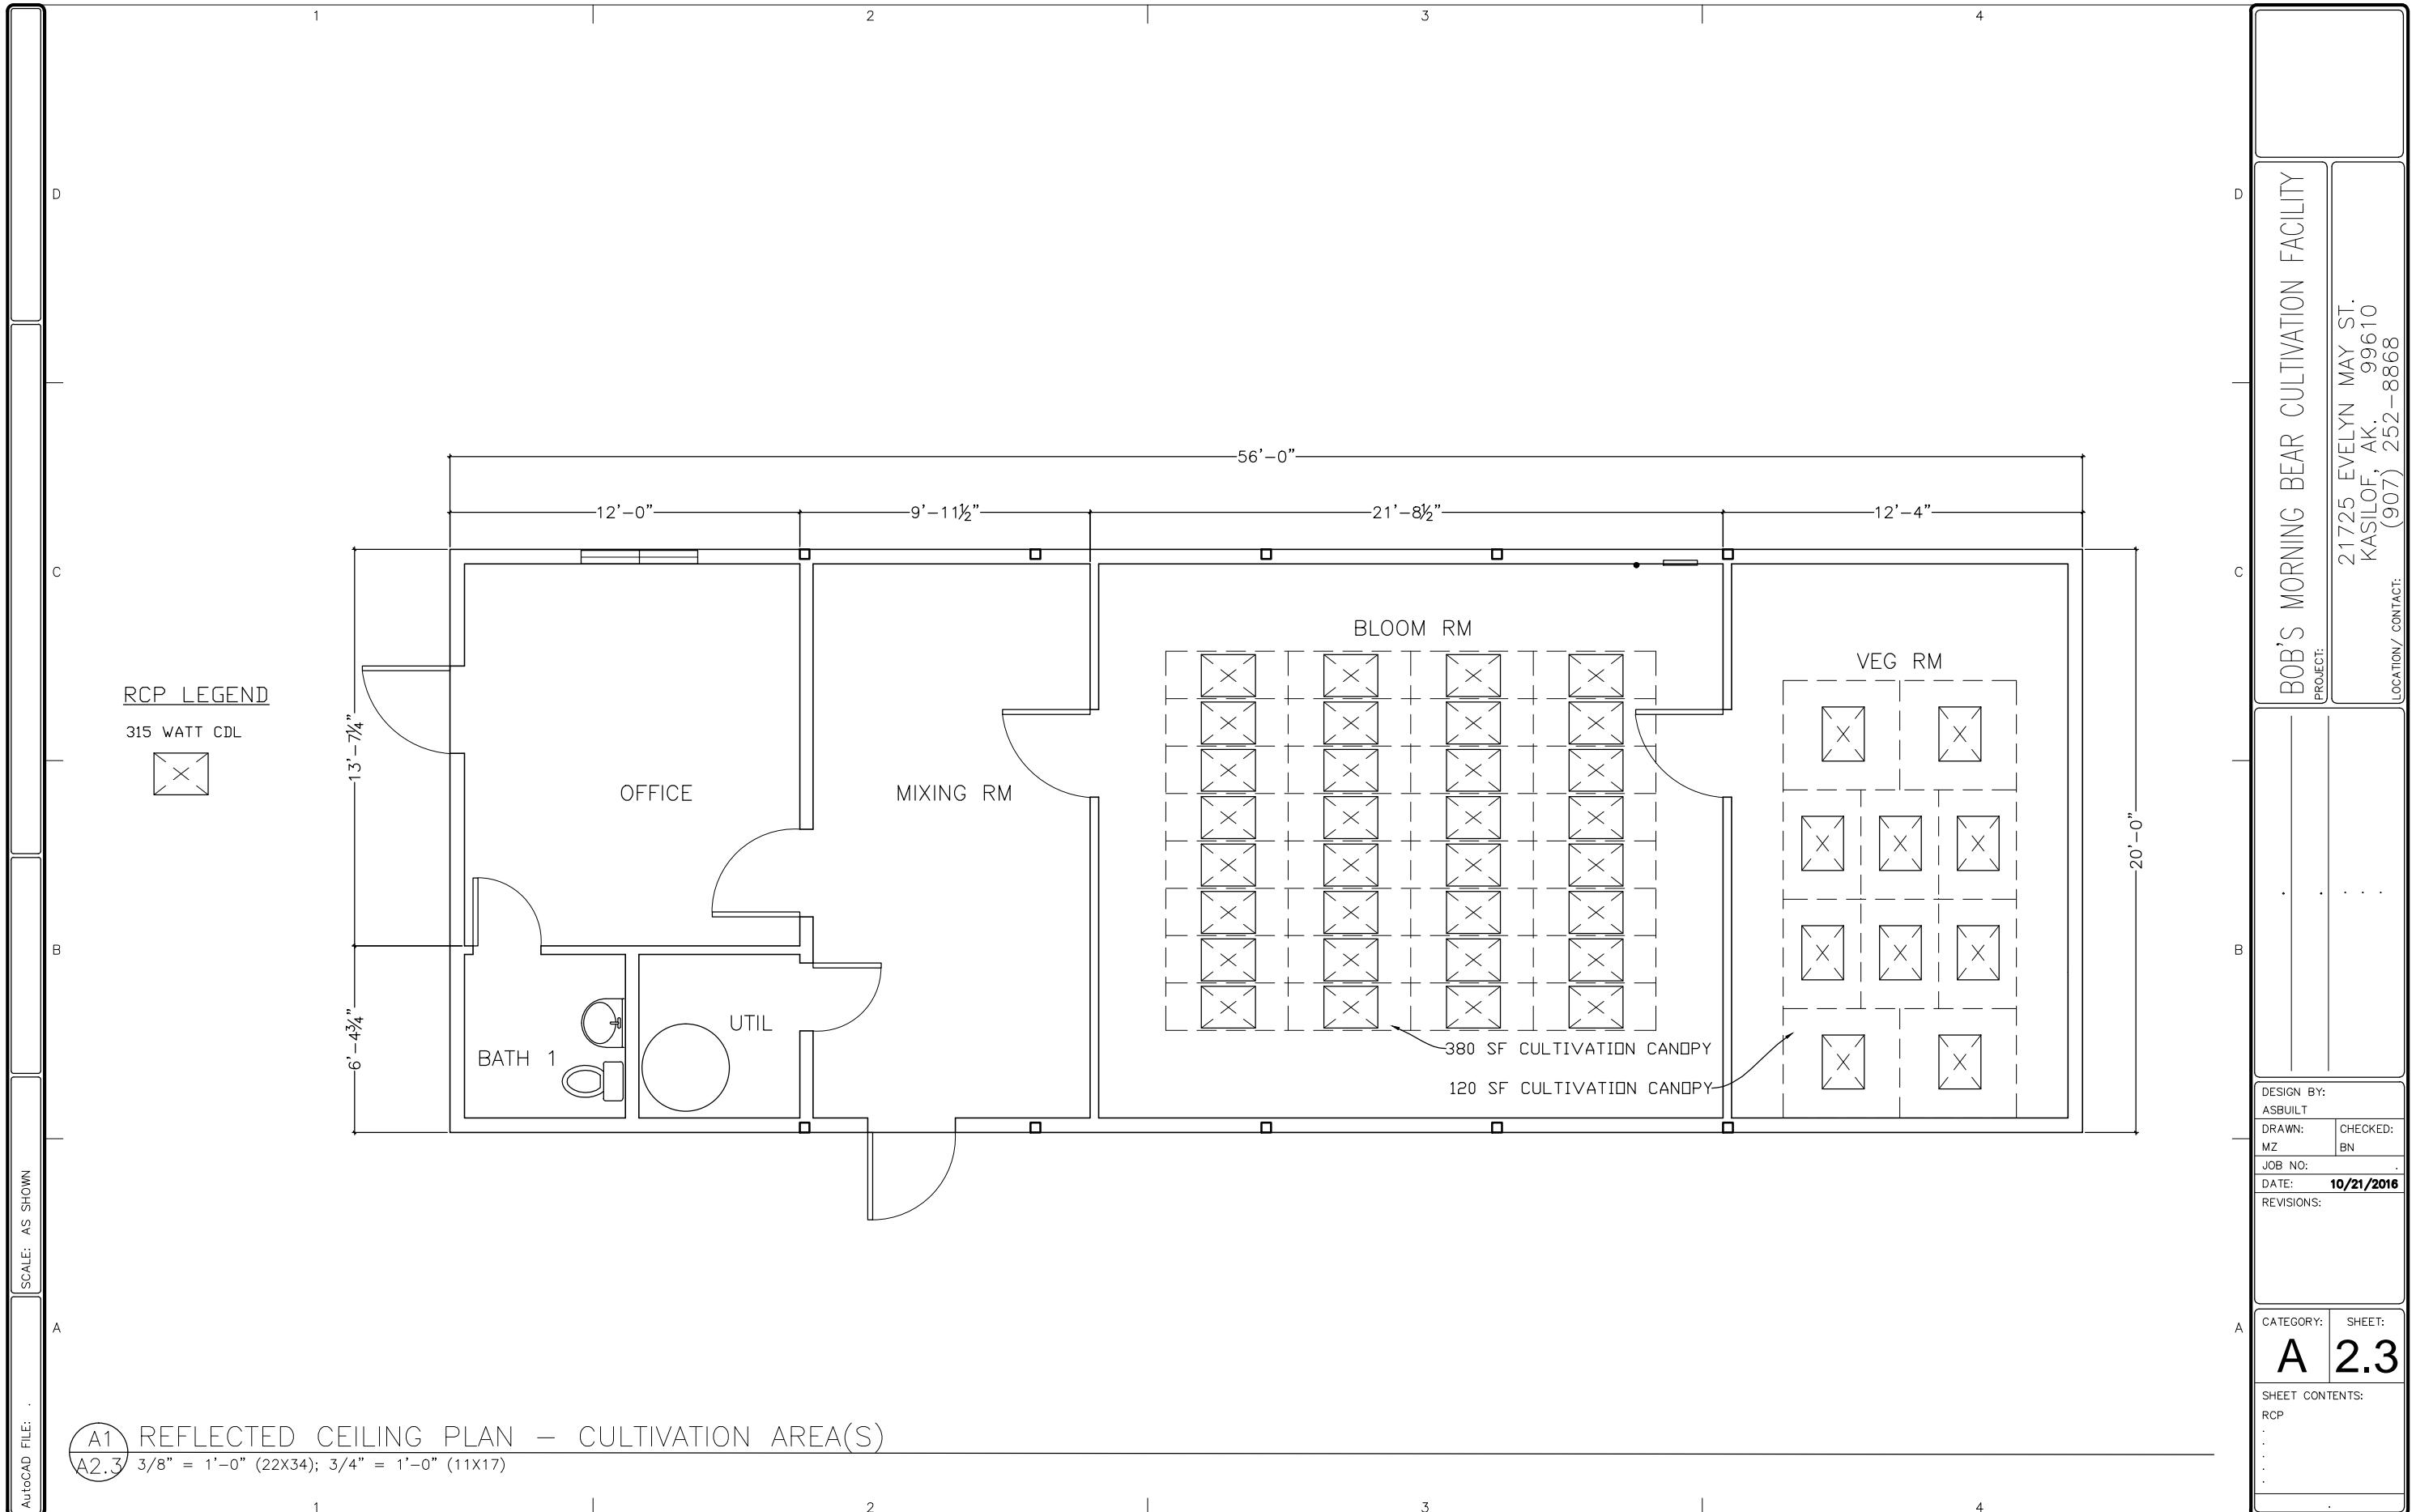

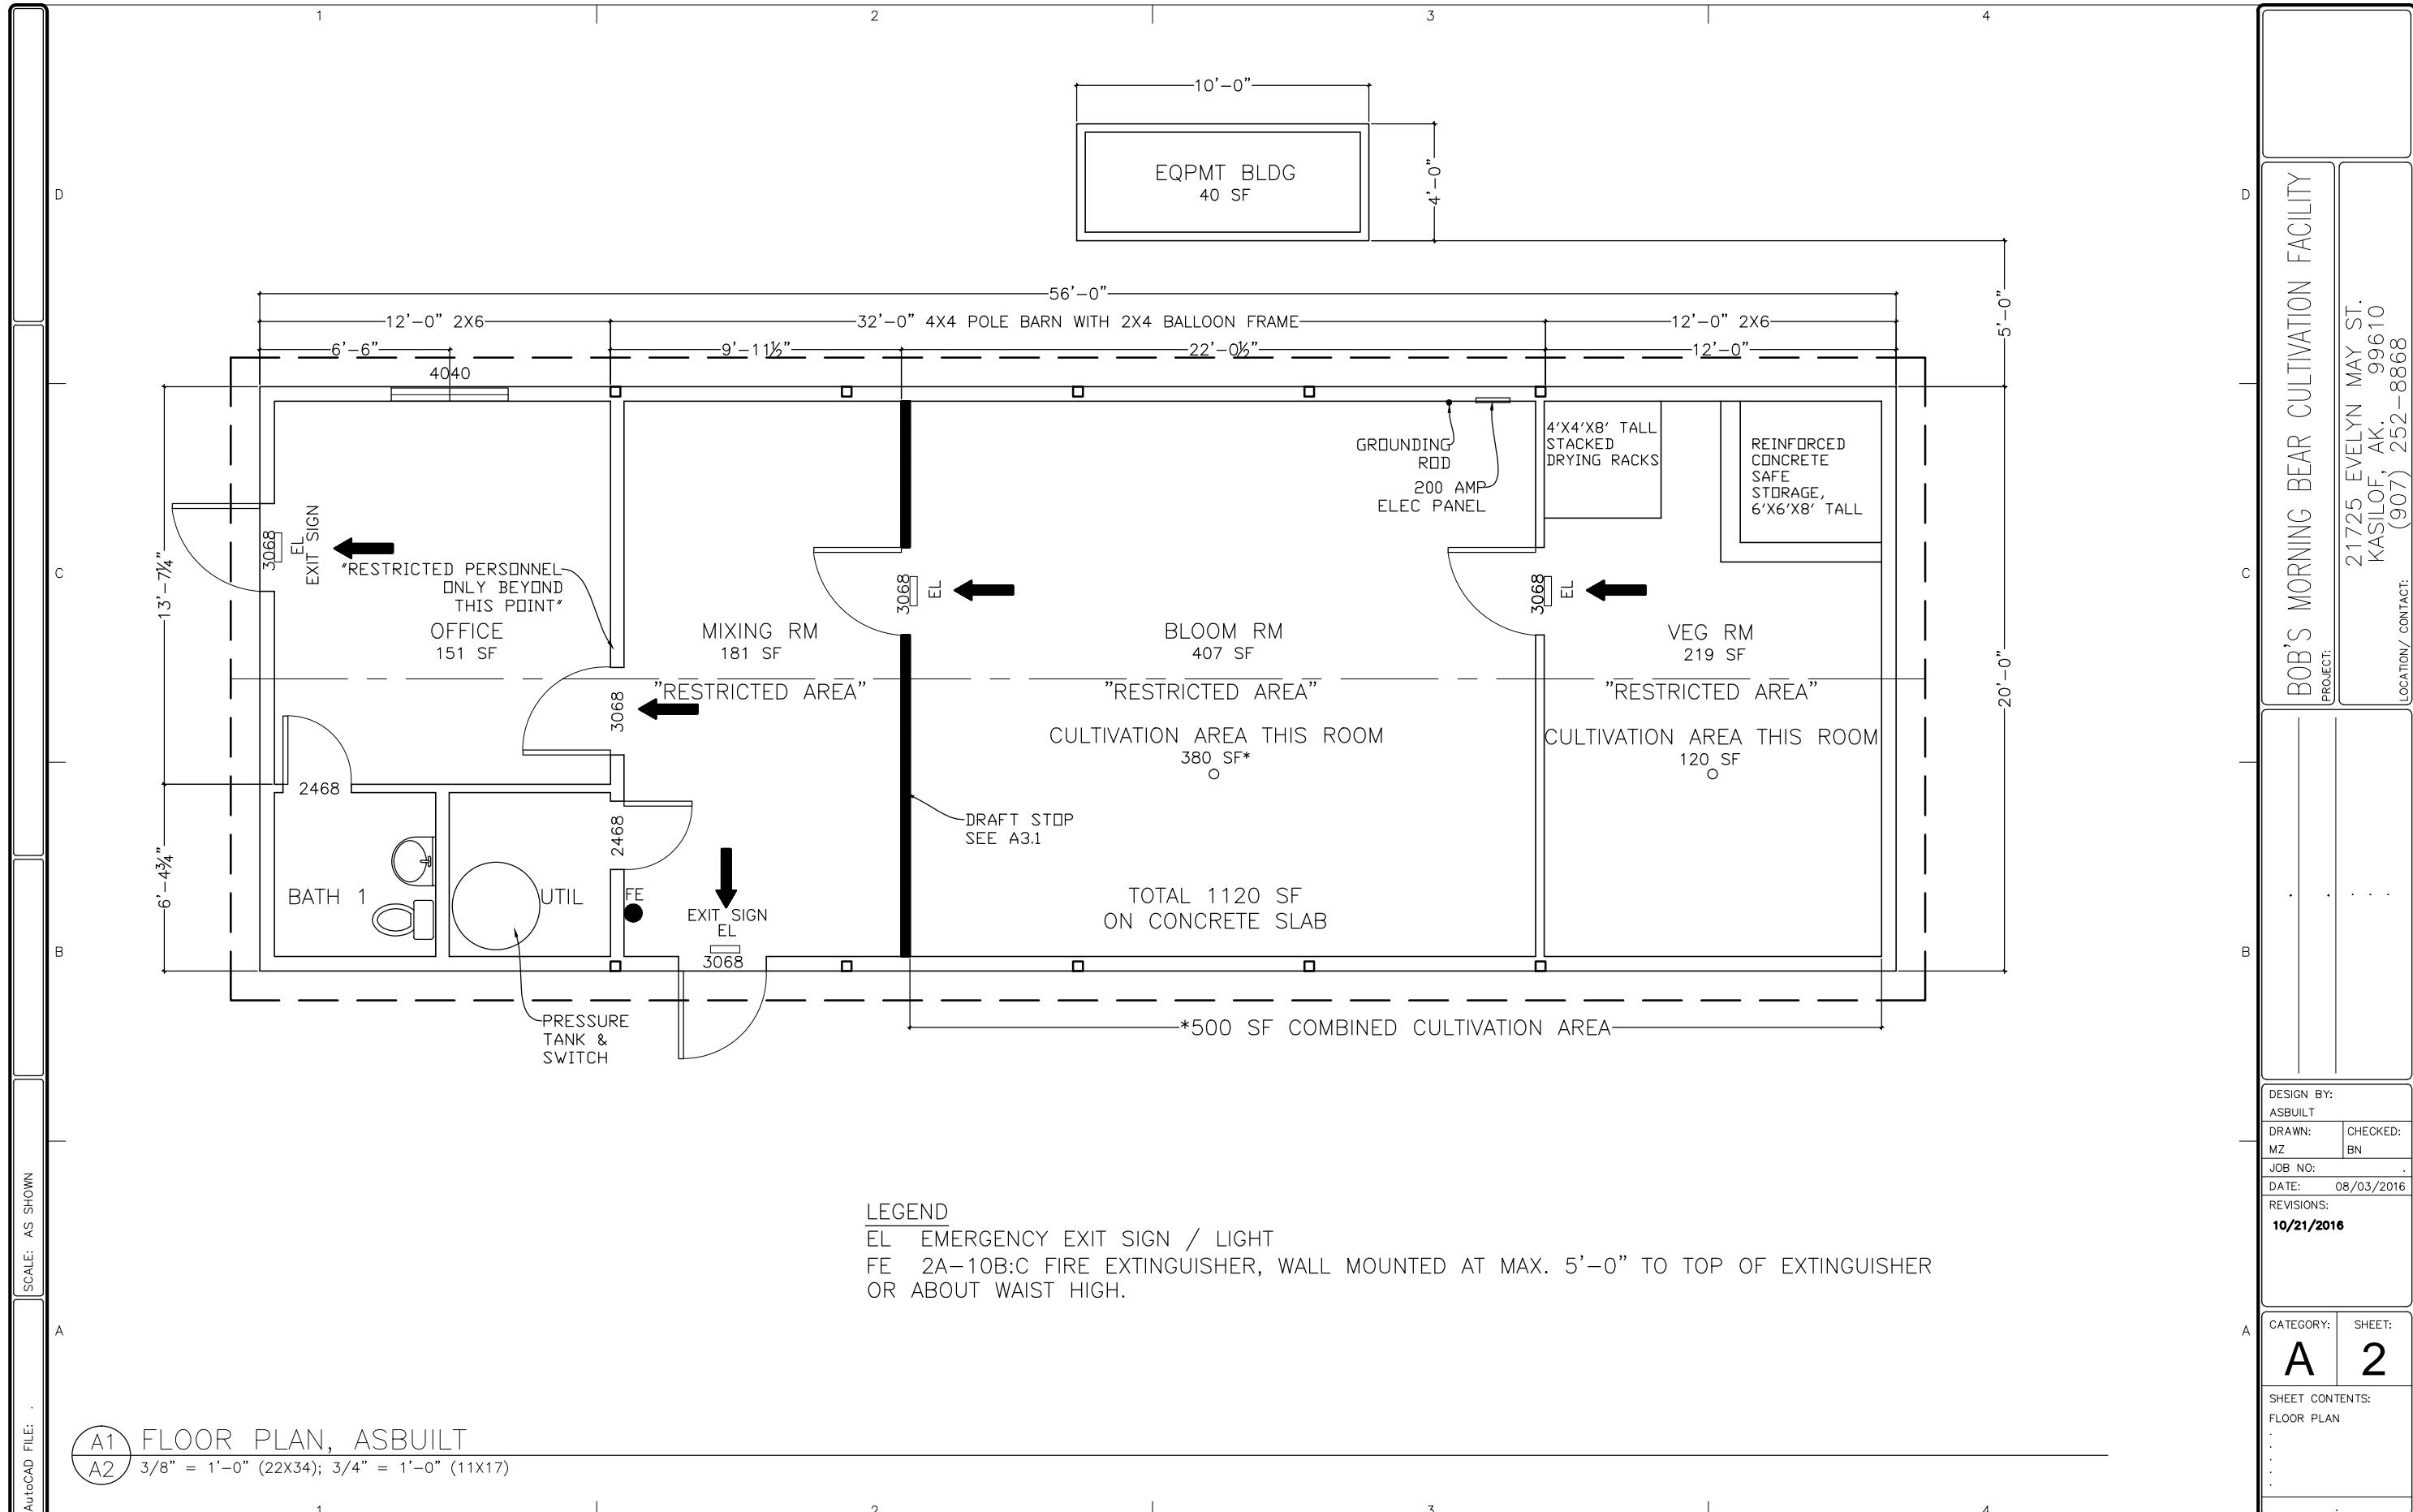

A1 FLOOR PLAN, AS BUILT  
A2 3/8" = 1'-0" (22X34); 3/4" = 1'-0" (11X17)

KPB 7.30.020(C)(1)

1120 SF LICENSED PREMISE	PARKING SPACES PROVIDED
PARKING	5
LOADING	1
LICENSED PREMISE EMPLOYEES	
FULL TIME EMPLOYEES	2
PART TIME EMPLOYEES	3-5

THE PREMISE IS ACESSED FROM A BOROUGH MAINTAINED STREET. A 24'-0" WIDE SECURE KEYED ACCESS GATE IS PROVIDED FOR LOADING AND OFF-LOADING. EMERGENCY ACCESS IS PROVIDED BY SECURE KEYED ACCESS GATE AND A CLEAR FIRE LANE IS DESIGNATED.

LOT COVERAGE IS LESS THAN 30%.

LOT AREA IS 43,226.9 SF.

LICENSED PREMISE  
EXSTG 56' X 20'  
1120 SF FACILITY

LICENCED PREMISE  
EXSTG 56' X 20',  
1120 SF FACILITY

WELL AT XX'  
XX GPM

150'-0"

308.0' N 89° 59' 5" E

308.0' N 89° 59' 5" E

OFF STREET

FIRE LANE

FIRE LANE

74'-2"

CLEANOUT

10'X4' EQPMT BLDG

68'-7½"

78'-1½"

24'-0"

22'-0"

140.0' N 0° E

24'-0"

24'-0"

16'-0" SECURE KEYED GATE

SHARED DRIVEWAY

1000 GAL STEEL SEPTIC TANK

60' DRAINAGE FIELD

8'

ENVELOPE MAY SIX

N

SHEET NOTE: A  
THIS SITE PLAN DEVELOPED USING KENAI  
PENINSULA BOROUGH GIS DATA; LOCATION  
DIMENSIONS MAY BE APPROXIMATE.

21/23 EVELYN MAY ST.  
KASLILOF, AK. 99610  
(907) 252-8868

LOCATION / CONTACT:

SHEET:  
1

A1 ASBUILT SITE AND SECURITY PLAN  
C1 1" = 20'-0" (22X34); 1" = 40' (11X17)

