

Lot 8


Block One

Lot 9

Lot 10

Hillside Drive 60' ROW

Lot 9 Block Two

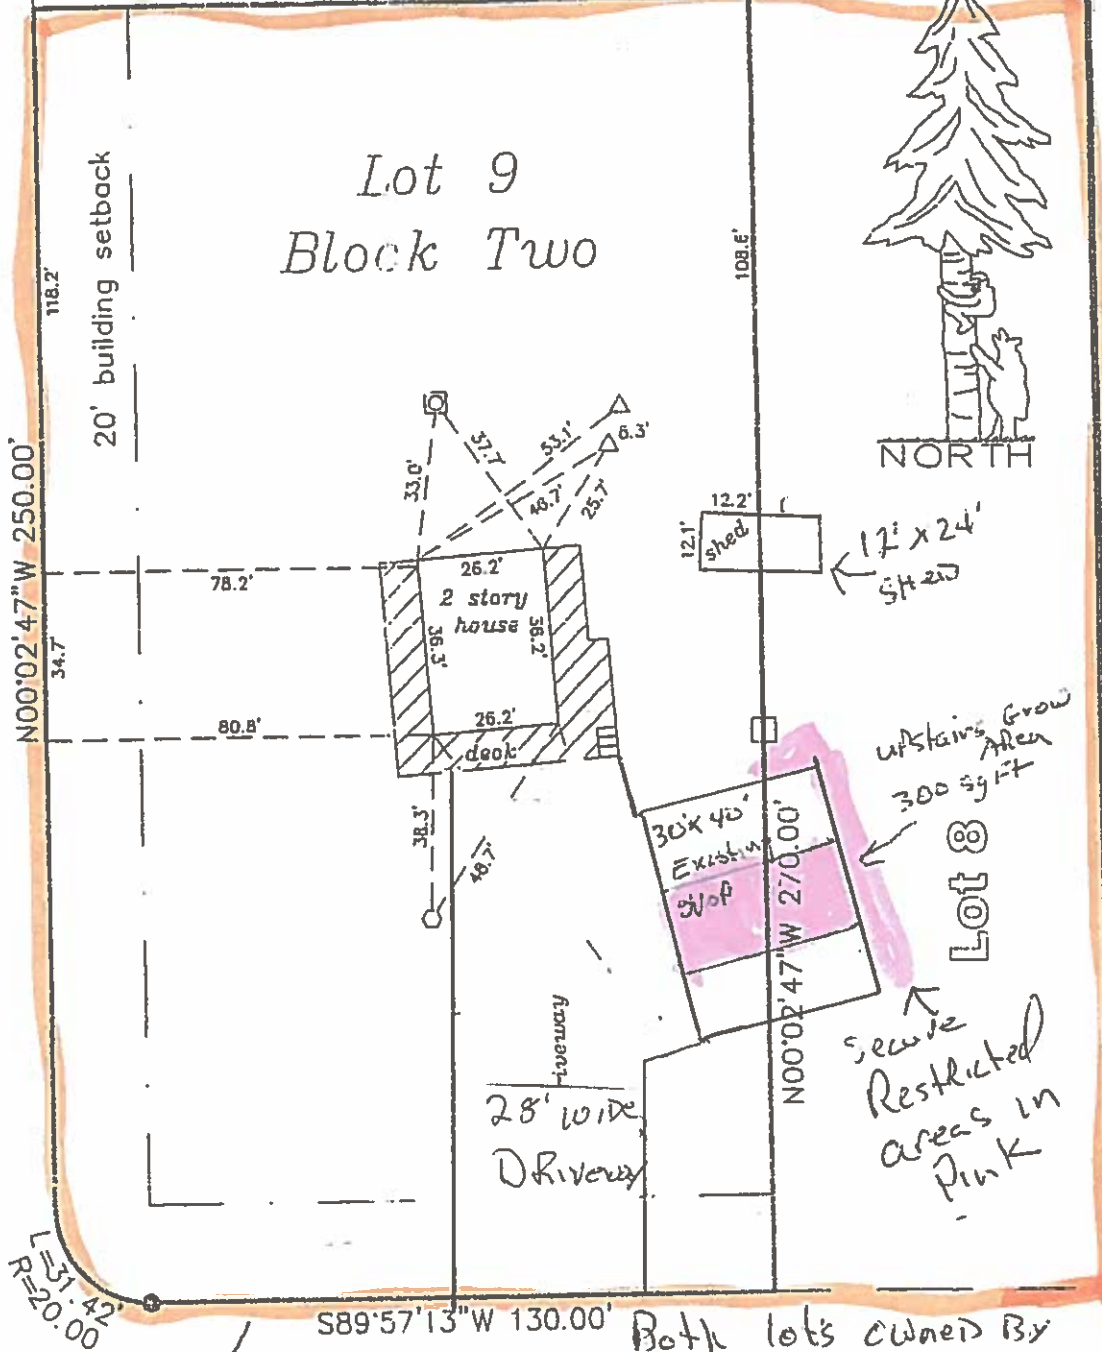

Cliff Baker

Owned Premises in orange

Both lots owned by Dennis R & Tena L. Humphrey

Lot 1

Block Three

Lot 2

AS-BUILT CERTIFICATION

LEGEND

- ▤ Satellite Dish
- Well
- Rebar/Pipe (found)
- △ Vent Pipe

Scale: 1"=40'

F.B. #: 02-6, pg. 74

KENAL RECORDING DISTRICT

As-Built Certificate

I hereby certify that the improvements hereon exist as shown on the following described property.

Lot 9 Block Two

Halbouty Heights Subdivision