

S89°57'13"W 150.00'

Lot 8

Block One

Lot 9

Lot 10

Hillside Drive 60' ROW

Lot 9
Block Two


ALL BUILDINGS are
Existing




N00°02'47"W 250.00'

20' building setback


0.3' Encroachment

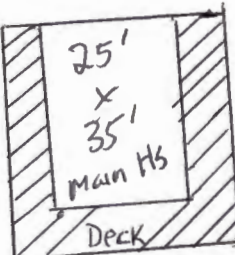

bird bath

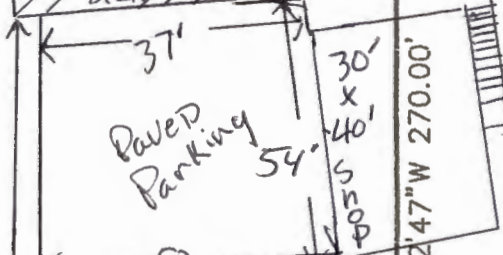

Starts TO
GROW
Area
Lot 8

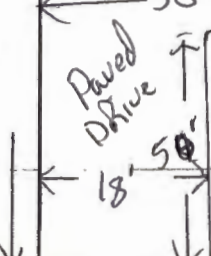

Driveway To Be
Extended To
28' width
Summer 2017

L=31.42'
R=20.00'

S89°57'13"W 130.00'

60' ROW

Halbouty Lane (Heights Lane)

Lot 1

Block Three

Lot 2

AS-BUILT CERTIFICATION

LEGEND

- ☉ Satellite Dish
- Well
- Rebar/Pipe (found)
- △ Vent Pipe

Scale: 1"=40'

F.B. #: 02-6, pg. 74

KENAI RECORDING DISTRICT


As-Built Certificate

I hereby certify that the improvements hereon exist
as shown on the following described property.

Lot 9 Block Two

Halbouty Heights Subdivision

COMPANY High Tide Distributors DEPT. _____
SUBJECT _____
LOCATION _____ BY _____ DATE _____

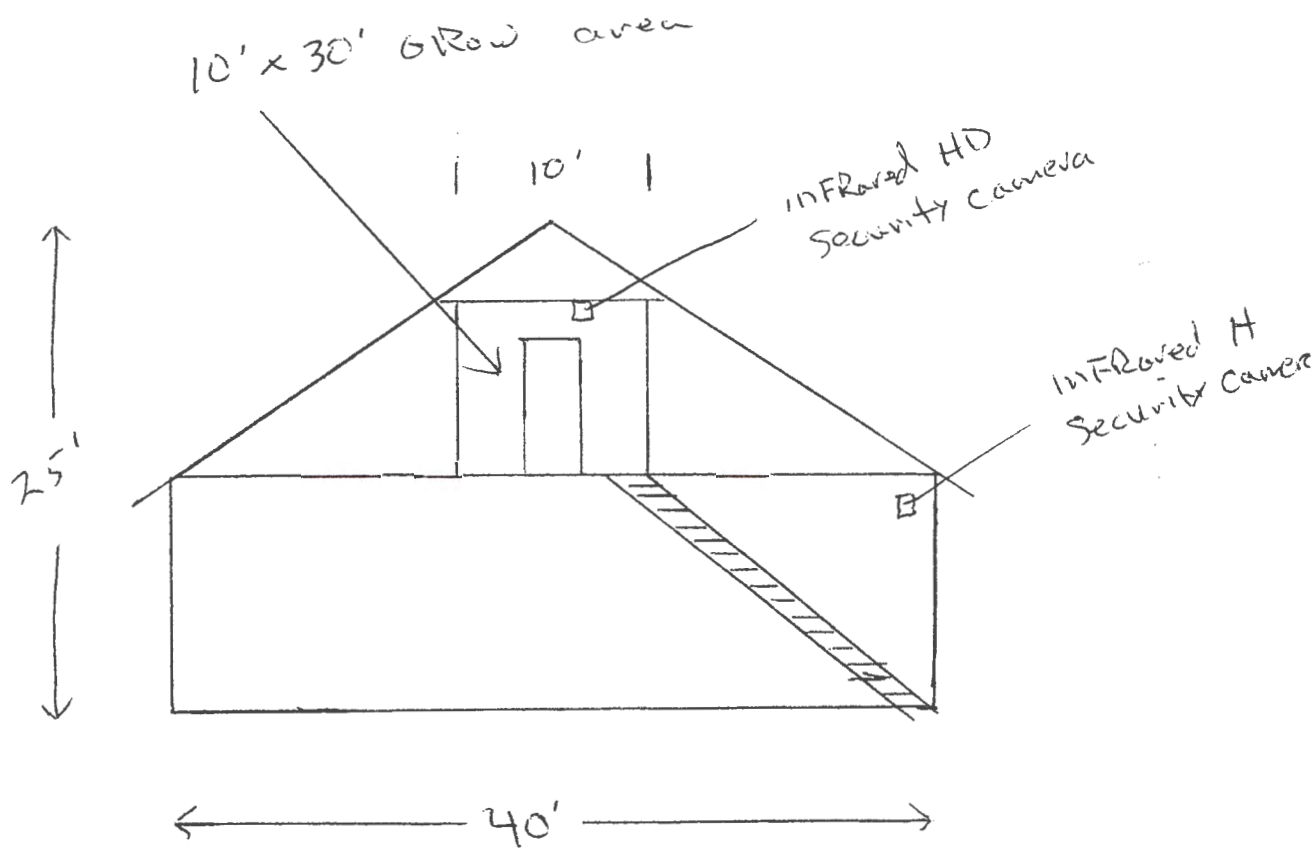

COMPANY *High Tide Distributors*

DEPT.


SUBJECT

LOCATION

BY

DATE

FRONT VIEW

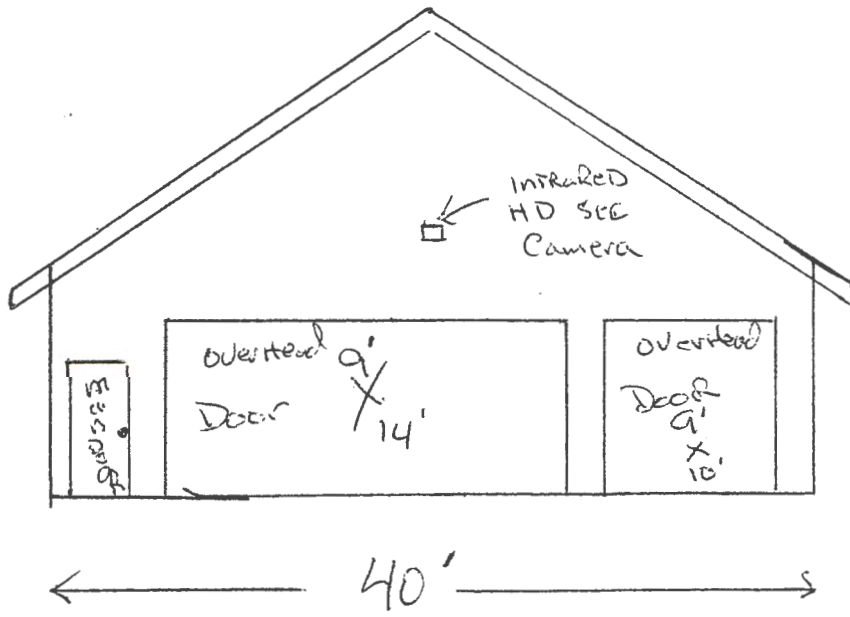

COMPANY High Tide Distributors


DEPT. _____

SUBJECT _____

LOCATION _____

BY _____

DATE _____

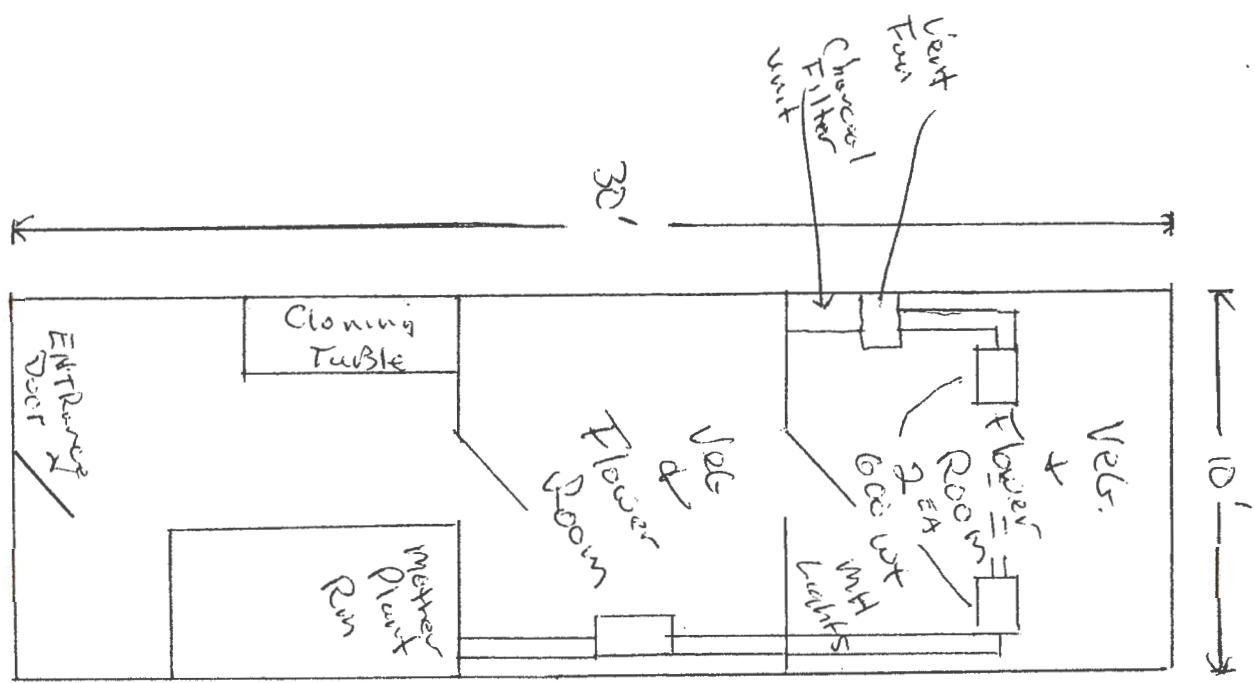

→ Less than
300 SQ. FT.
Total area

Installed HD
Cameras throughout
@ Kiosk camera