
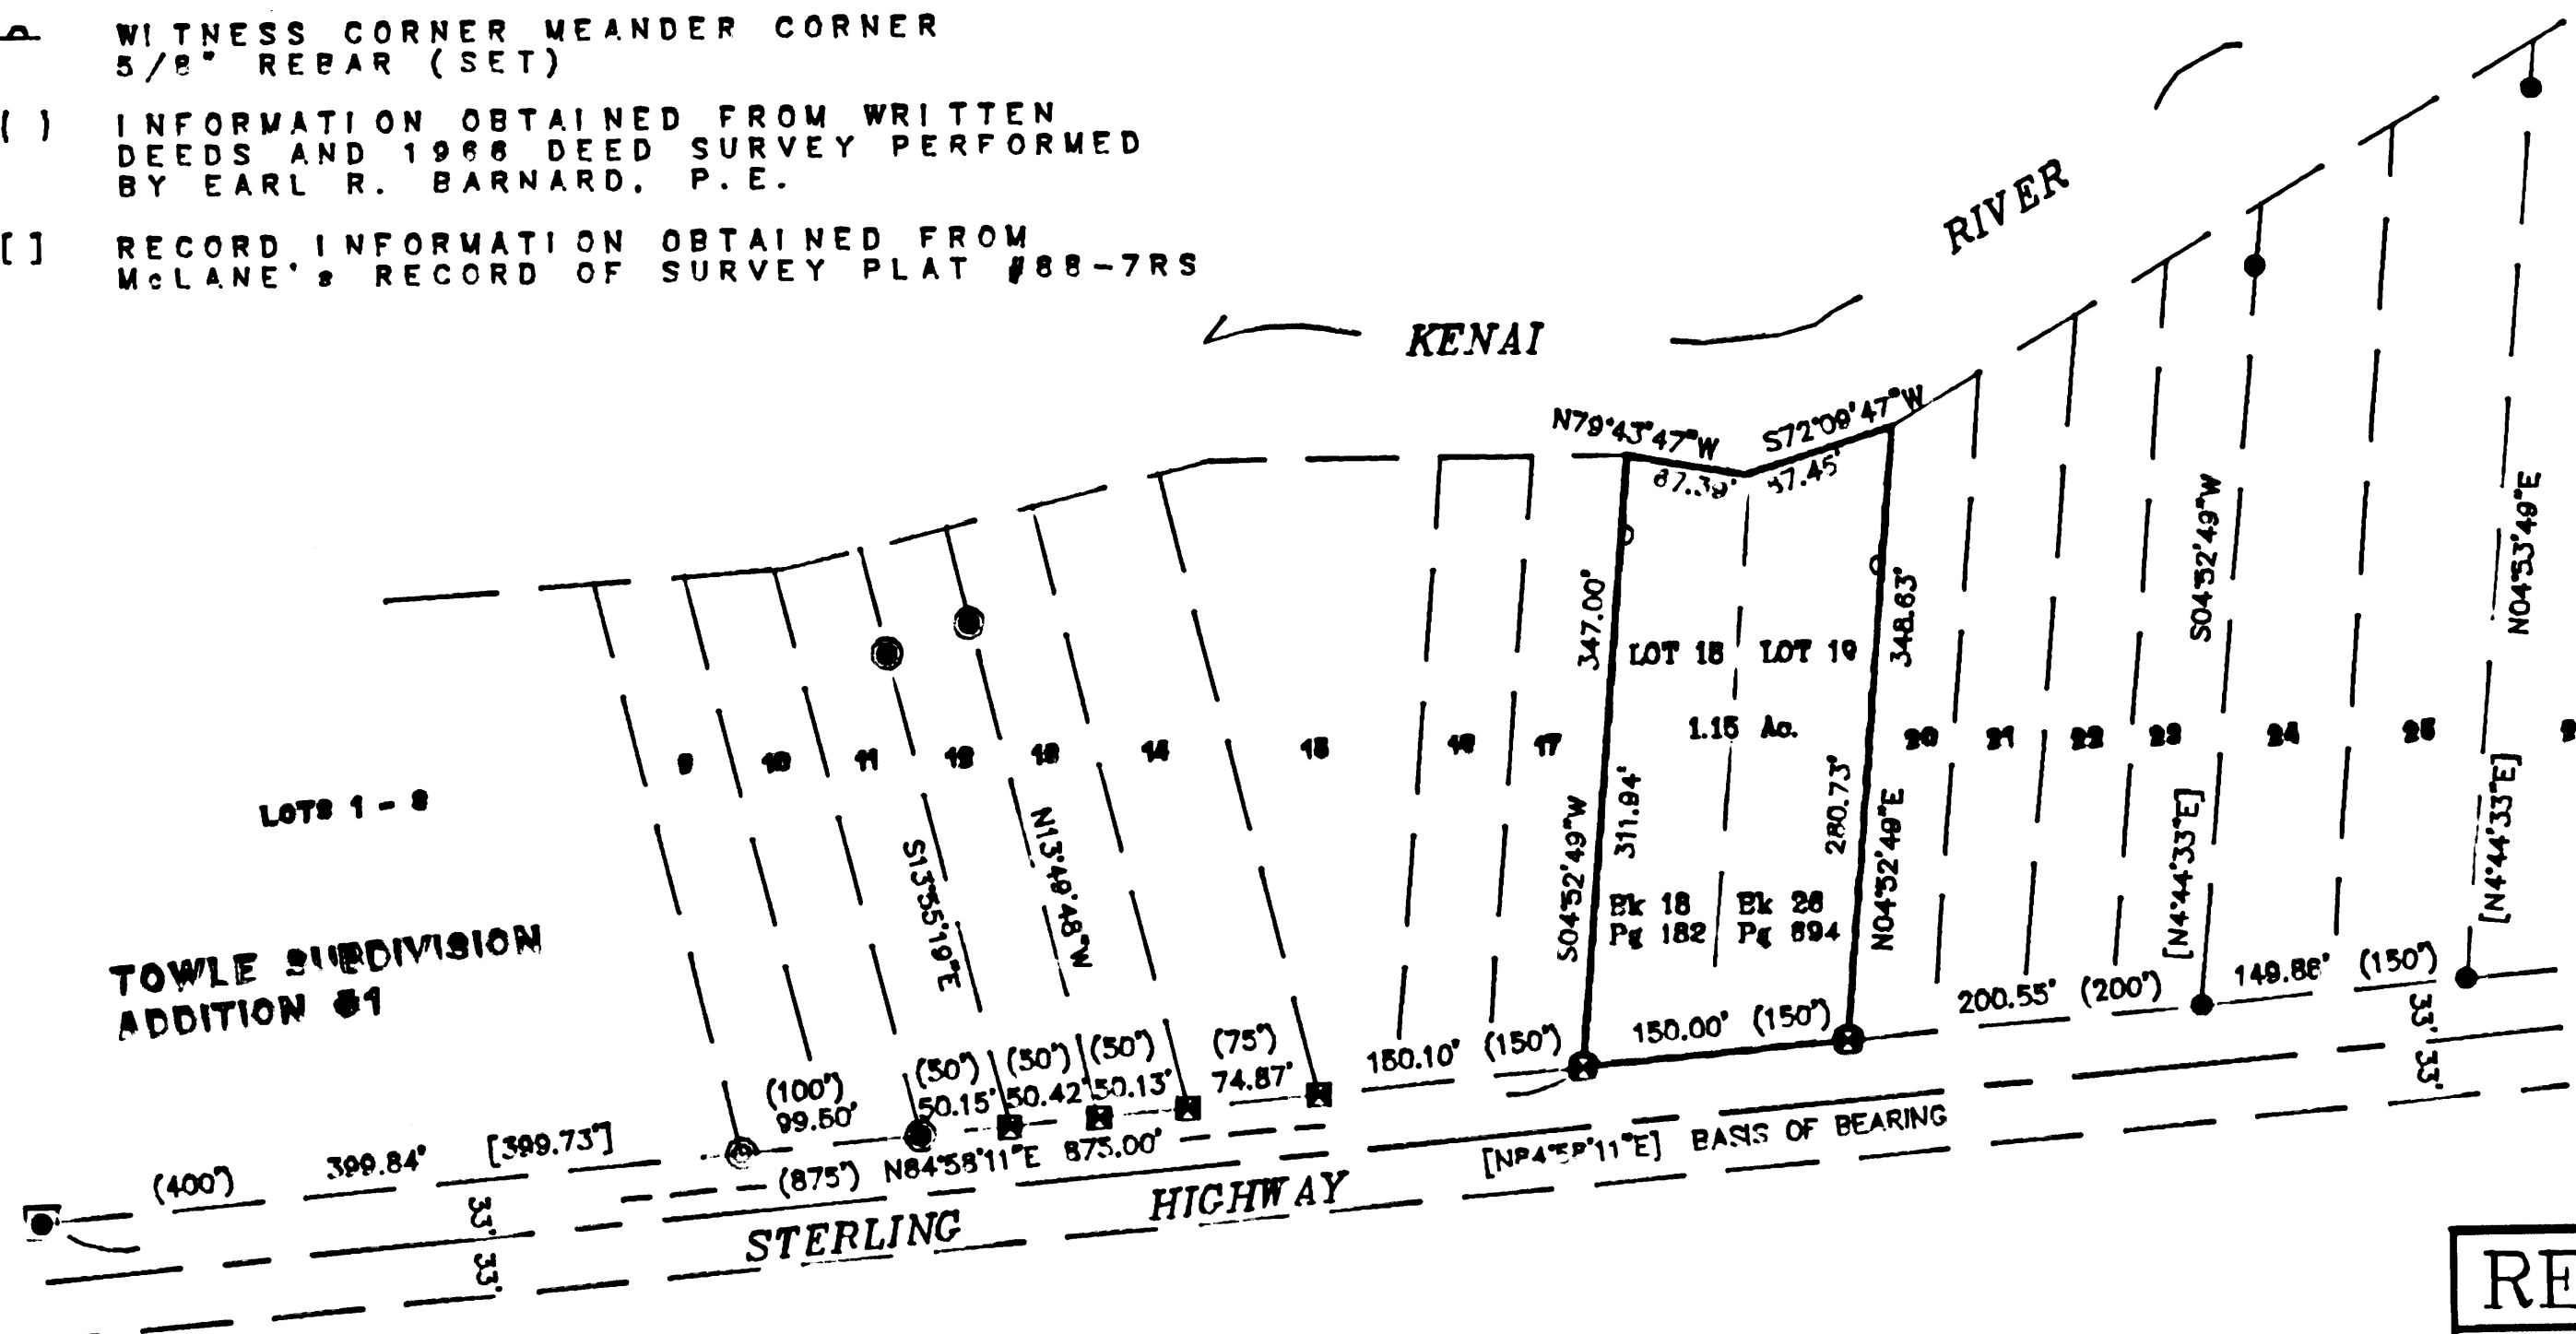


LEGEND:

- 6"x6" WOOD POST WITH 1/2" REBAR IN CENTER FLUSH WITH SHOULDER (INITIAL POINT TOWLE SUBD. #1)
- ⊙ 1 1/2" I.D. IRON PIPE (FOUND)
- 1 1/2" O.D. IRON PIPE (FOUND)
- HUB & TACK (FOUND)
SET BY EARL R. BARNARD, P. E.
1986 DEED SURVEY OF LOTS 9-19
- 5/8" REBAR (SET)
DRIVEN THROUGH FOUND HUB
- 1/2" REBAR (FOUND)
- △ WITNESS CORNER MEANDER CORNER
5/8" REBAR (SET)
- () INFORMATION OBTAINED FROM WRITTEN DEEDS AND 1986 DEED SURVEY PERFORMED BY EARL R. BARNARD, P. E.
- [] RECORD INFORMATION OBTAINED FROM McLANE'S RECORD OF SURVEY PLAT #88-7RS

NOTES:

- 1) THIS SURVEY DOES NOT CONSTITUTE A SUBDIVISION AS DEFINED BY A.S. 40.15.190(2). THIS IS A DEED OF RECORD SURVEY OF DEEDS RECORDED BOOK 18 PAGE 182 AND BOOK 28 PAGE 894 IN THE SEWARD RECORDING DISTRICT.
- 2) THE NORTH LOT LINES ARE THE NORMAL HIGH WATER LINE OF THE KENAI RIVER. THE NORTH LINE SHOWN IS FOR COMPUTATIONS ONLY.
- 3) THE BASIS OF BEARING IS THE CENTERLINE OF THE STERLING HIGHWAY, WHICH IS THE SAME BEARING USED ON EARL R. BARNARD'S 1986 DEED SURVEY AND McLANE'S RECORD OF SURVEY PLAT #88-7RS.

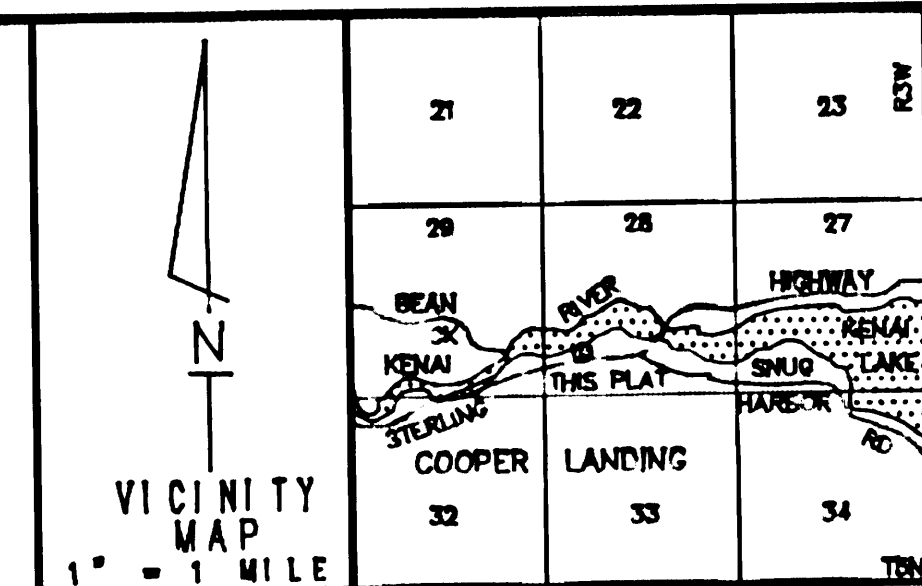



SURVEYOR'S CERTIFICATE

I hereby certify that; I am properly registered and licensed to practice land surveying in the State of Alaska, this sketch represents a survey made by me or under my direct supervision, the monuments shown herein actually exist as described, and all dimensions and other details are correct to the normal standards of practice of land surveyors in the State of Alaska.

Date 5/1/89

Clifford E. Baker C. E. Baker

Registration Number LS 5152

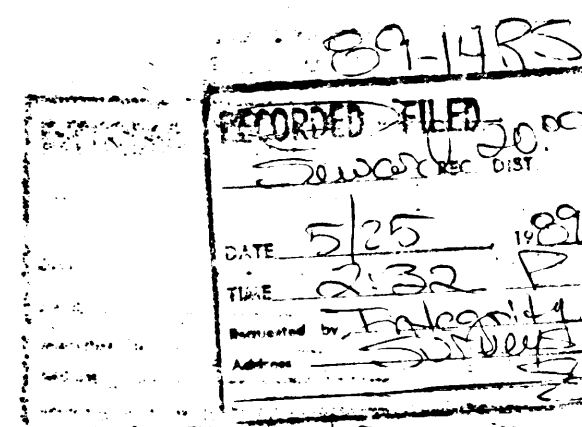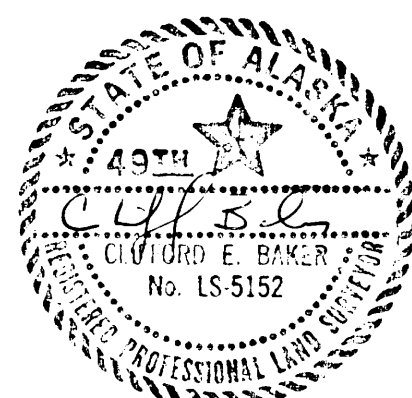

RECORD OF SURVEY

OF
LOTS 18 & 19 TOWLE SUBDIVISION No. 1
WITHIN
HOMESTEAD ENTRY SURVEY No. 95
SECTION 28 (PROTRACTED), T5N, R3W, S. M.,
SEWARD RECORDING DISTRICT, KENAI PENINSULA
BOROUGH, ALASKA.

INTEGRITY SURVEYS

HC2 BOX 385 SOLDOTNA, ALASKA 99669
SURVEYORS 2629461 PLANNERS

DATE OF SURVEY: MAY 4-5, 1989	DRAWN BY & DATE: CB, MAY 7, 1989
CHECKED BY: CB	SCALE: 1" = 100'
FIELD BOOK: 89 - 1	FILE #: 89 - 44 DISK #: 05 - 20