

CERTIFICATION:

I HEREBY CERTIFY THAT I HAVE SURVEYED THE LOCATION OF THE IMPROVEMENTS ON TRACT-B OF FORT MOREAN SUBD. ADDY (83-229) amended KKC, A.K.

1. SAID IMPROVEMENTS ARE WITHIN THE PROPERTY LINES AS SHOWN HEREON
2. NO IMPROVEMENTS ON THE ADJOINING PROPERTY ENCRACH ON TRACT-B
3. NO ROADWAYS, TRANSMISSION LINES, OR OTHER VISIBLE EVIDENCE OF EASEMENTS CROSS TRACT-B.

AS-BUILT SURVEY BY
TERRY T. EASTHAM RSL 7629
P.O. BOX 2891
SOLDOTNA, ALASKA
99669

June 5, 2003


PROPERTY LINE 1287'



TRACT-B
19.50 acres



Scale:
1"=100'

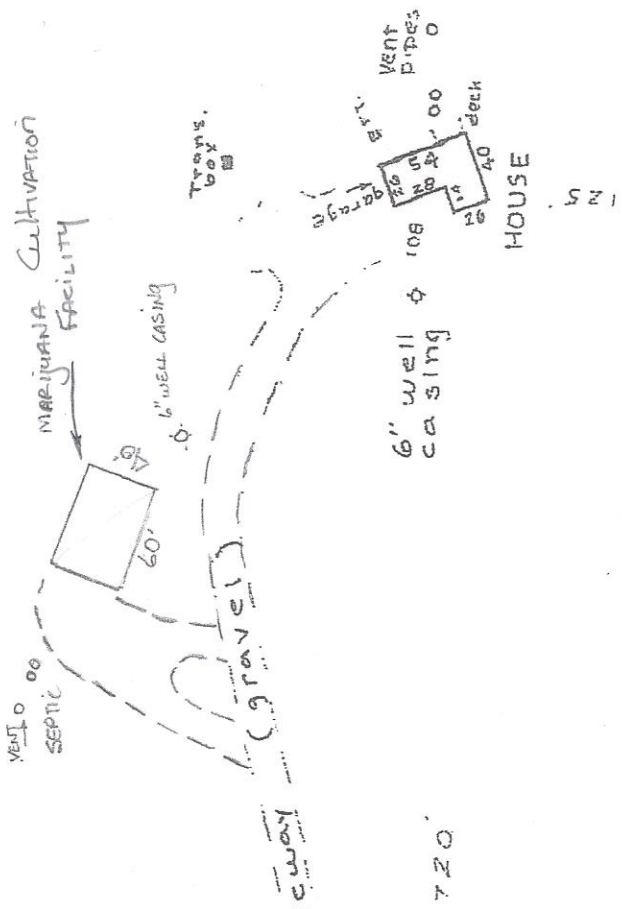

POLLARD STREET 38' R/W GRAVEL

UTILITY - 1287' - EASEMENT