

CERTIFICATION:


I HEREBY CERTIFY THAT I HAVE SURVEYED THE LOCATION OF THE IMPROVEMENTS ON TRACT B of FORT MORGAN SUBD. ADD I (83-229) amended KRD, A.K.

1. SAID IMPROVEMENTS ARE WITHIN THE PROPERTY LINES AS SHOWN HEREON
2. NO IMPROVEMENTS ON THE ADJOINING PROPERTY ENCROACH ON TRACT B
3. NO ROADWAYS, TRANSMISSION LINES, OR OTHER VISIBLE EVIDENCE OF EASEMENTS CROSS TRACT B.

AS-BUILT SURVEY BY

TERRY T. EASTHAM RSL 7629
P.O. BOX 2891
SOLDOTNA, ALASKA
99669

June 5, 2003

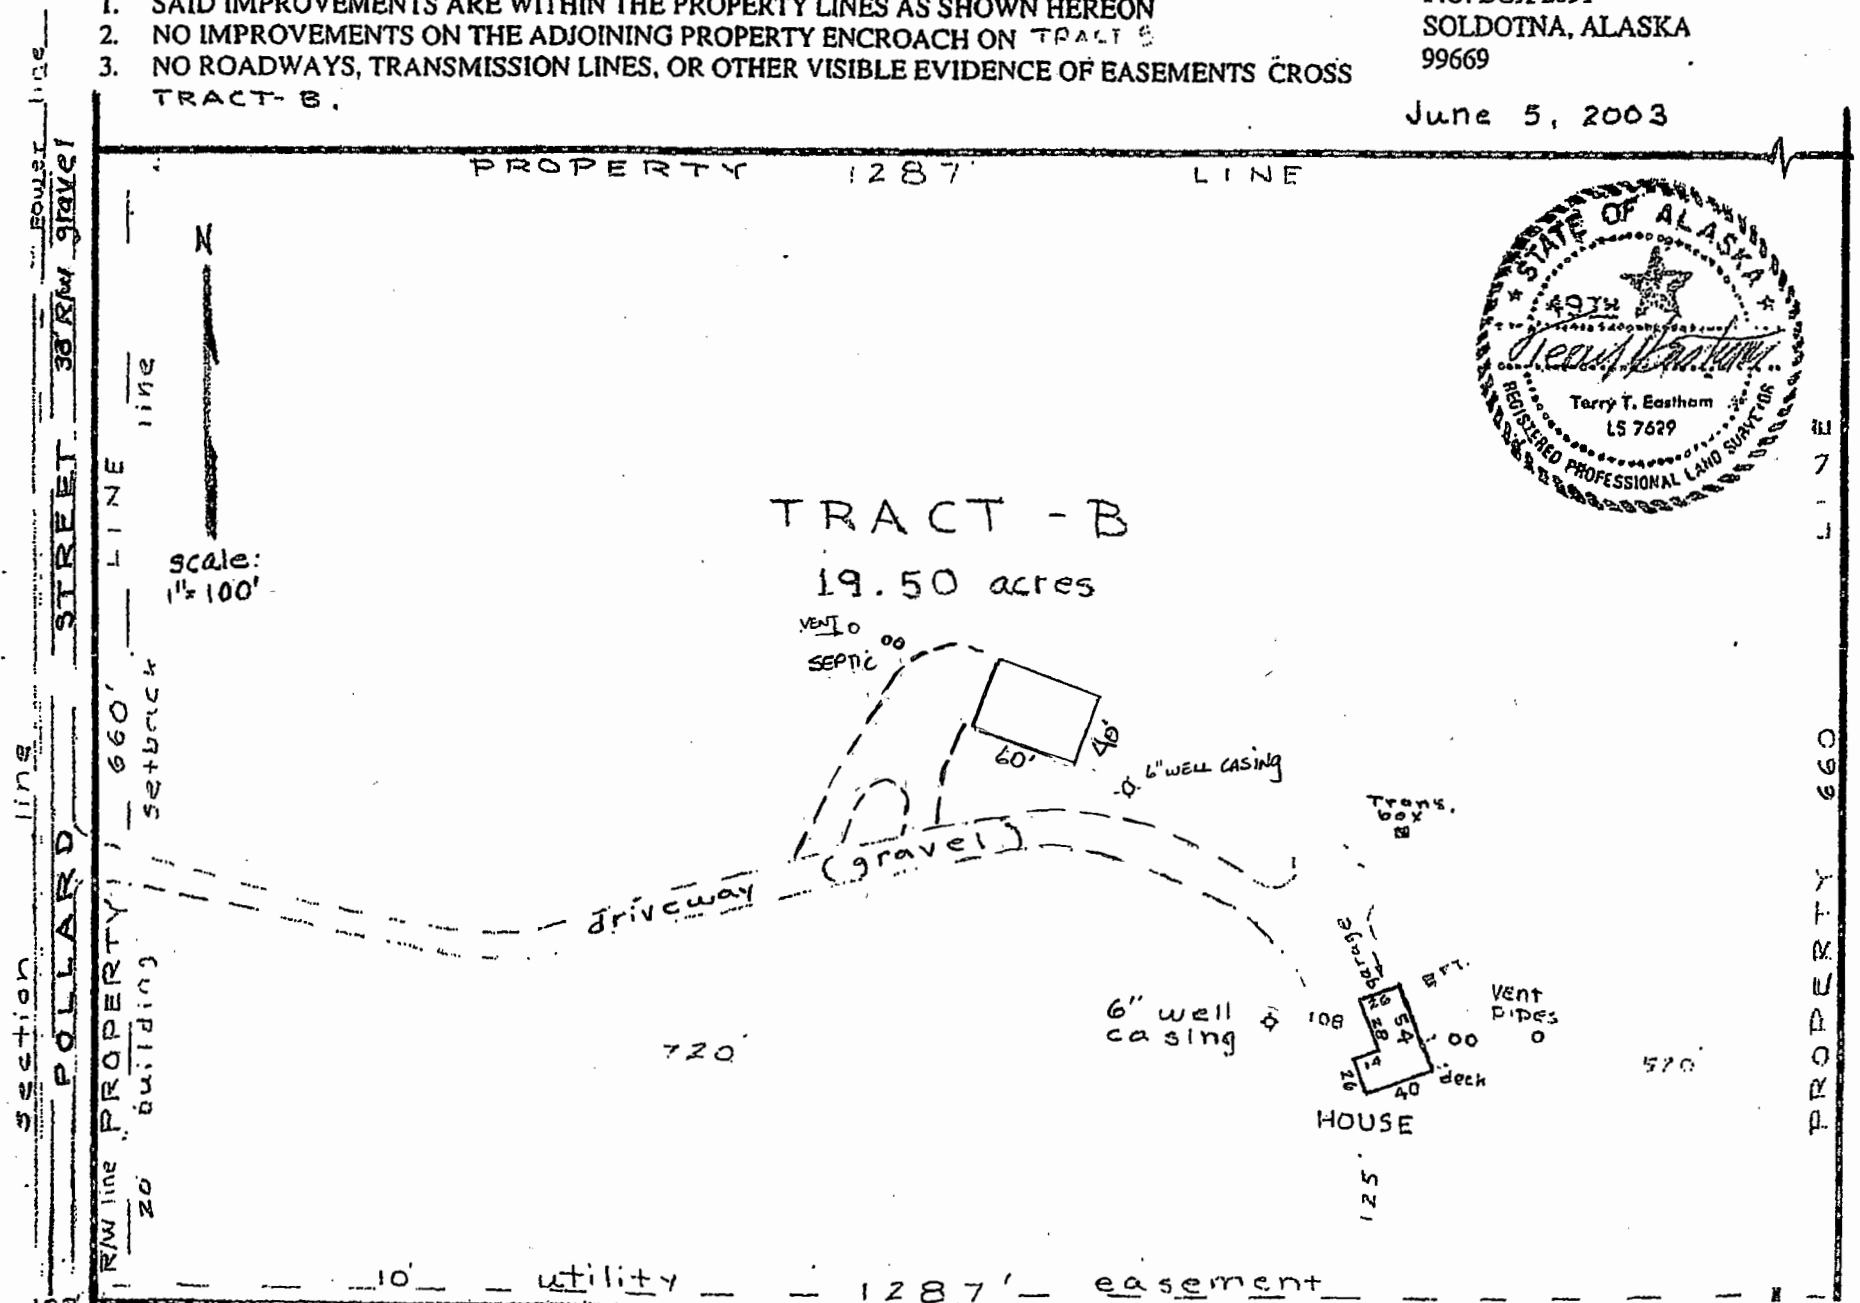


POR. SEC. 32 & 33, T03N, R11W, S.M.

120

133-511

RIVER ROAD TRACTS SUB KN0740100
 FORT MORGAN SUB KN0750170
 FORT MORGAN SUB ADDN 1 TRACTS B & C KN0830229
 DETTINGER SUB KN0850078
 BYINGTON HOMESTEAD SUB WHISPERWOOD ADDN KN0890058
 BYINGTON HOMESTEAD WHISPERWOOD ADDN KN0830058
 FORT MORGAN SUB HORSETRAIL ADDN KN0940059
 BYINGTON HOMESTEAD 1996 ADDN KN0980037
 BYINGTON HOMESTEAD 1998 ADDN KN0980065
 BYINGTON HOMESTEAD KN0980036
 RIVER ROAD TRACTS KASILVER ADDN KN0980090
 BYINGTON HOMESTEAD 2001 ADDN KN2001088
 PROMISED LAND KN2003085
 BYINGTON HOMESTEAD 2005 ADDN KN2008009
 GRANT FRITZ SUB #4 KN2012073
 BYINGTON HOMESTEAD 2013 ADDN KN2013098

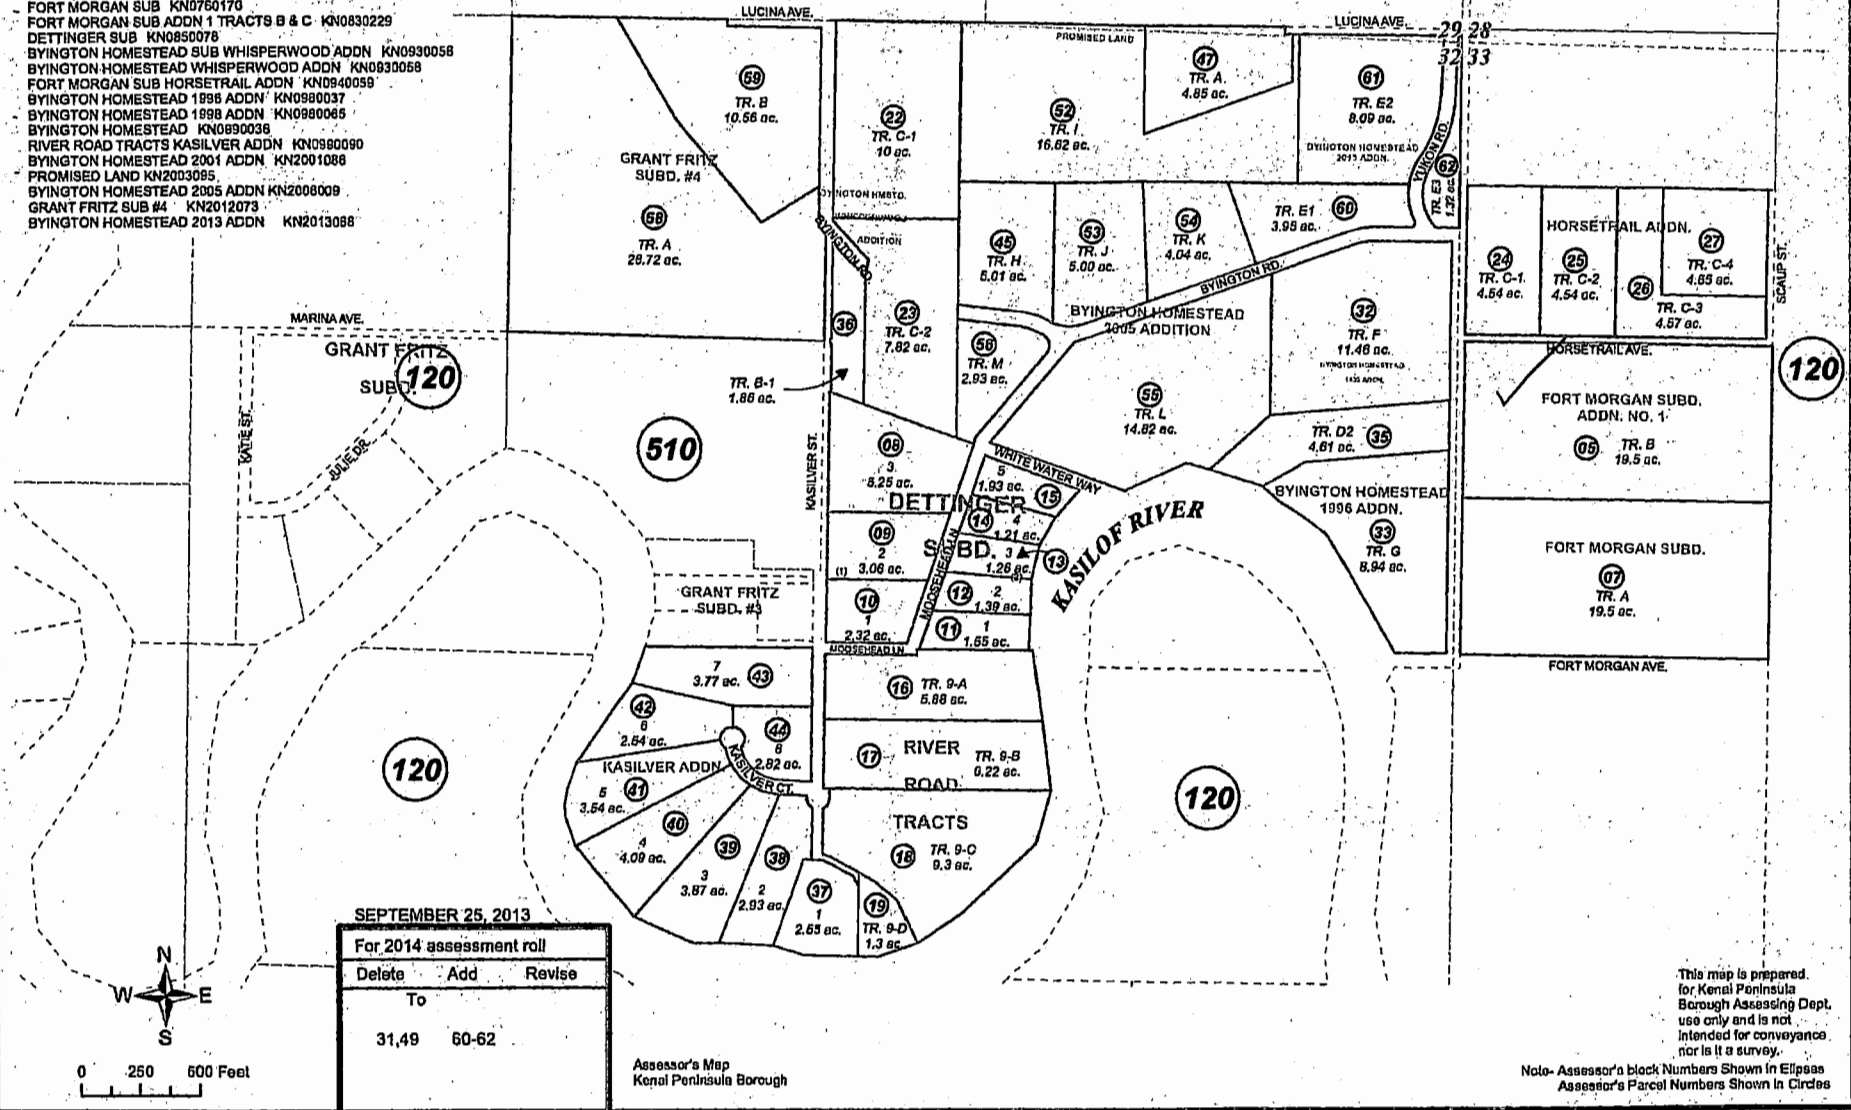

SEPTEMBER 25, 2013

For 2014 assessment roll

Delete	Add	Revise
To		
31,49	60-62	

Assessor's Map
 Kenai Peninsula Borough

This map is prepared for Kenai Peninsula Borough Assessing Dept. use only and is not intended for conveyance nor is it a survey.
 Note- Assessor's block Numbers Shown in Ellipses
 Assessor's Parcel Numbers Shown in Circles

28 27
33 34



93-229
RECORDED - FILED 10-00
Kenai
DATE 10-14-83
TIME 9:28
BY Michael P. McLane
Notary Public

(N 0° 05' W. — 5280.00')


**NOTARY'S ACKNOWLEDGEMENT
FOR ALVIN R. SHUCK**

Subscribed and sworn before me this
22 day of June, 1983.
My commission expires Aug. 31, 1983.
Alvin R. Shuck
Notary Public




**NOTARY'S ACKNOWLEDGEMENT
FOR RUTH POLLARD**

Subscribed and sworn before me this
2 day of August, 1982.
My commission expires 4/23/83.
Michael P. McLane
Notary Public for Alaska

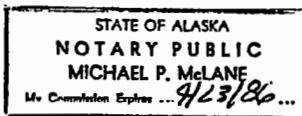

**NOTARY'S ACKNOWLEDGEMENT FOR
GEORGE POLLARD**

Subscribed and sworn before me this
30th day of April, 1982.
My commission expires 8/2/83.
Stanley S. Mc Lane
notary public for Alaska

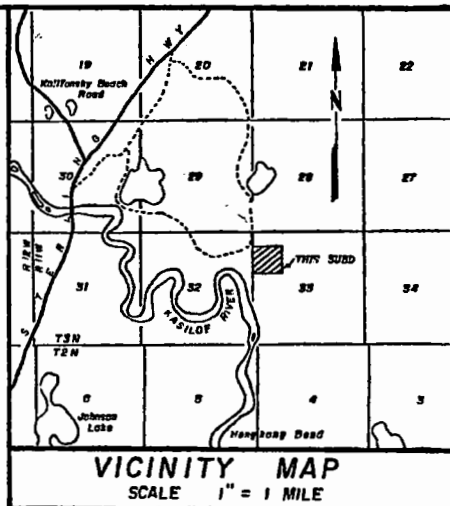

LEGEND AND NOTES

This plat is a paper plat of 40 acres subdivided by aliquot parts. No stakes or monument were set.

All bearings and distances refer to the GLO official plat of T3N, R11W, S.M., Ak.

Data of record shown in ().

All wastewater disposal systems shall comply with existing law at the time of construction.

93-23
RECORDED - FILED 10-00
Kenai
DATE 2-28-83
TIME 2:28
BY Michael P. McLane
Notary Public

PLAT APPROVAL

This plat was approved by the Kenai Peninsula Borough Planning Commission at the meeting of January 9, 1977.

Kenai Peninsula Borough

By: [Signature]
Authorized Official

AMENDED PLAT

**TRACT B AND C
FORT MORGAN SUBDIVISION ADDN. I**

George R. Pollard, owner
Box 40
Kasilof, Ak 99610

DESCRIPTION

S1/2 NW1/4 NW 1/4, N1/2 SW1/4 NW1/4 OF
SECTION 33, T3 N, R11 W, S.M., AK. CONTAINING
40 ACRES M/L IN THE KENAI PENINSULA
BOROUGH.

Prepared by: Mc Lane and Associates, Soldotna, Ak.

Date
December 8, 1977

Scale
1" = 200'

Bk. no.

to Tracts
89°57'45"W.
age made to
'00N.

Mc Lane
3932-S

33 34
4 3

A
LIC
2/83